




LEGEND

- Local Wet Scrubber
- Local Plenum Chamber
- Local Extraction Vent
- Main Wet Scrubber
- Waste Storage Area
- Stormwater Sullage Trench/Pit
- Air Emission Stack
- Transport Route
- Road Tanker Unloading Area

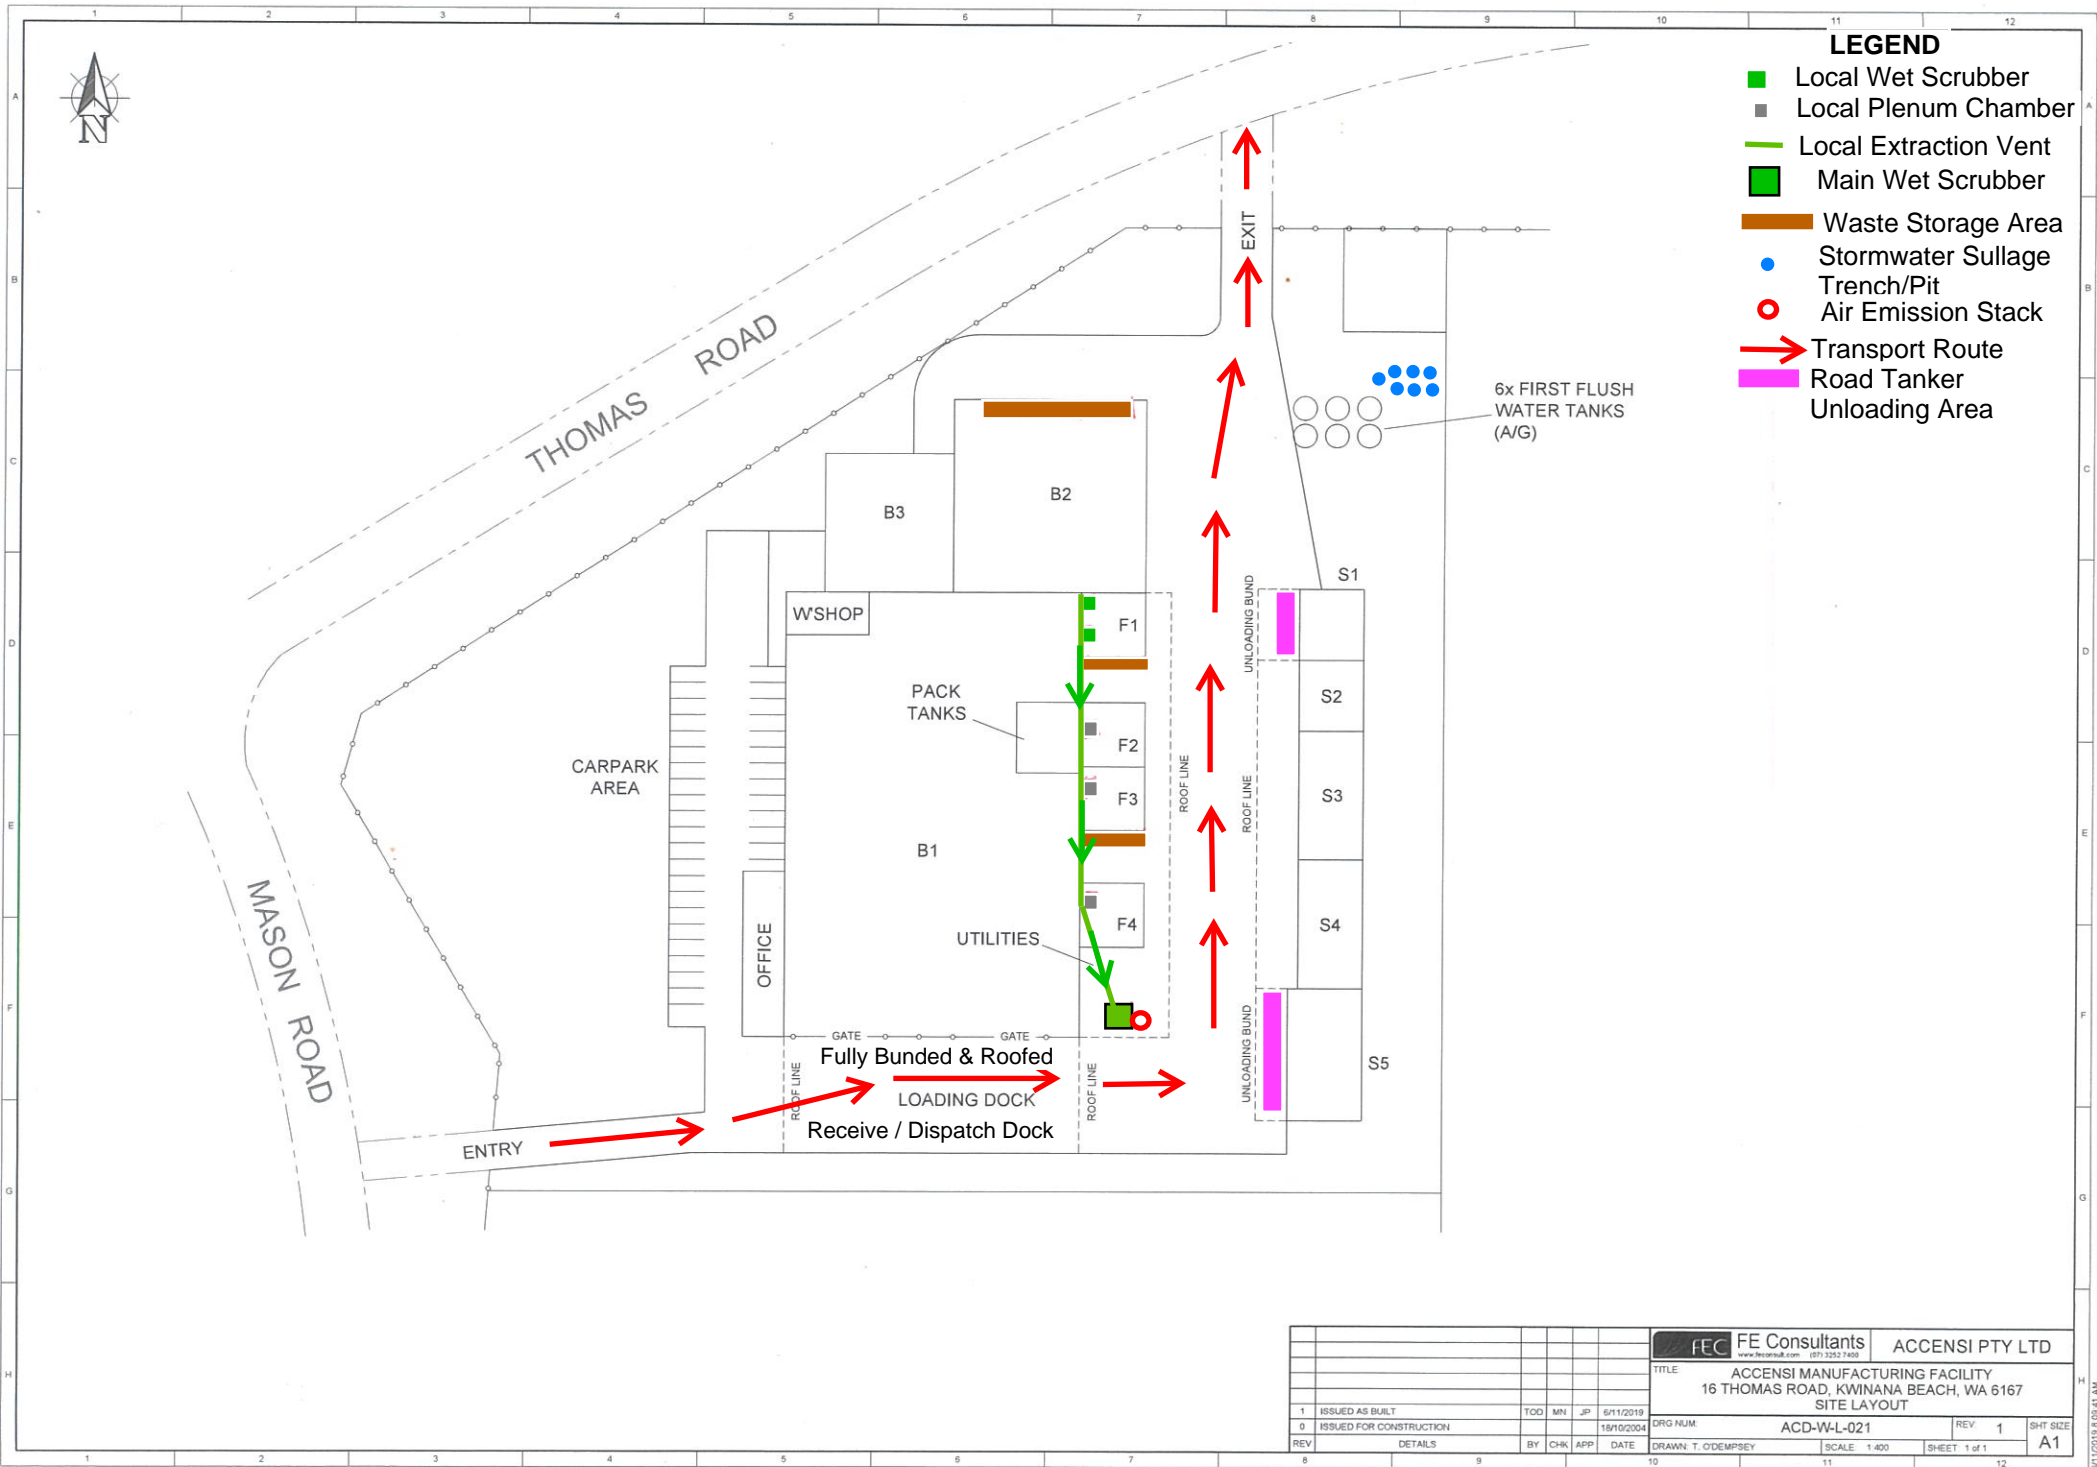

6x FIRST FLUSH WATER TANKS (A/G)

Fully Bunded & Roofed
LOADING DOCK
Receive / Dispatch Dock

				FE Consultants		ACCENSI PTY LTD	
				<small>www.feconsult.com (07) 3252 7400</small>			
TITLE ACCENSI MANUFACTURING FACILITY 16 THOMAS ROAD, KWINANA BEACH, WA 6167 SITE LAYOUT				DRG NUM ACD-W-L-021		REV 1	SHT SIZE A1
1 ISSUED AS BUILT	TOD	MN	JP	6/11/2019	18/10/2004	SCALE 1:400	SHEET 1 of 1
0 ISSUED FOR CONSTRUCTION	BY	CHK	APP	DATE	DRAWN: T. O'DEMPSEY	SCALE 1:400	SHEET 1 of 1

9/12/2019 2:04:41 AM