




IF IN DOUBT, ASK

JOINS OIP-7000-CI-PLN-1003

MATCHLINE

JOINS OIP-7000-CI-PLN-1004

MATCHLINE

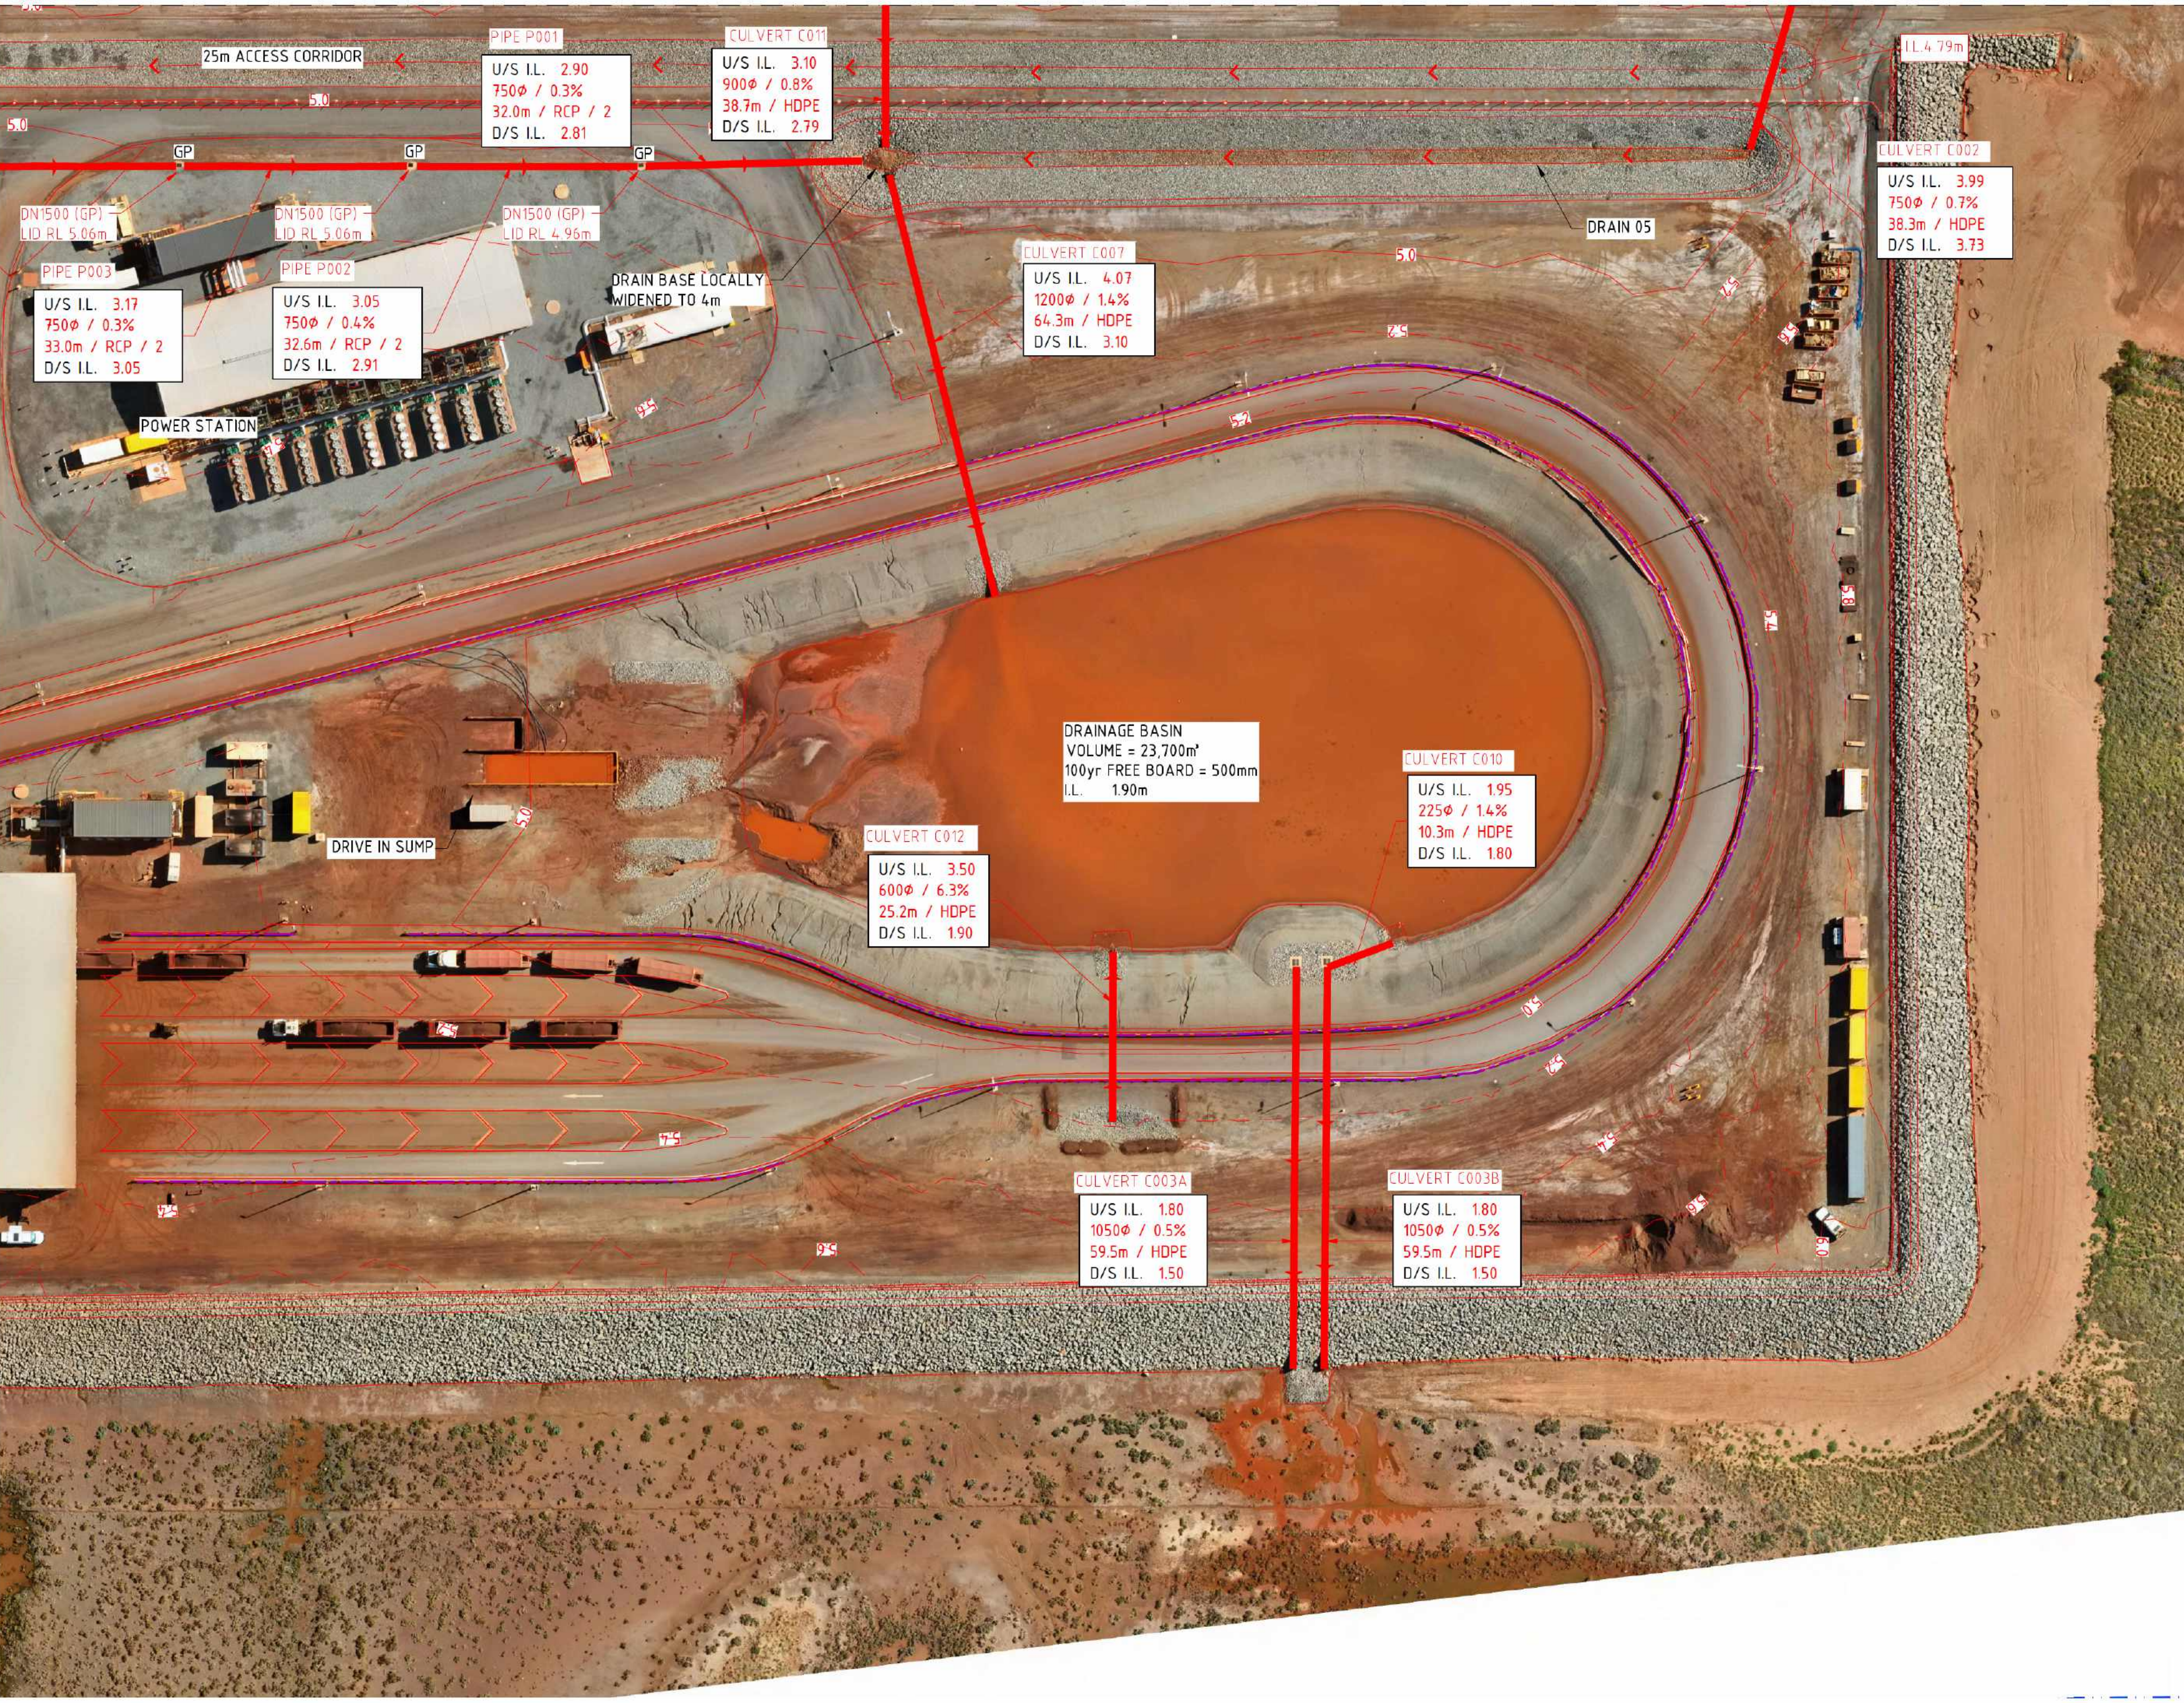

NOTES:

1. ALL COORDINATES ARE IN METRES TO MGA 94, ZONE 50.
2. ALL ONSHORE LEVELS ARE IN METRES TO AUSTRALIAN HEIGHT DATUM (AHD).
3. ALL DIMENSIONS ARE IN METRES U.N.O.
4. FOR CULVERT SCHEDULE REFER TO DRAWING OIP-7000-CI-SCH-1002.

LEGEND:

- 5.0 — AS BUILT CONTOURS MAJOR (1.0m INTERVAL)
- -5.2 — AS BUILT CONTOURS MINOR (0.2m INTERVAL)
- — BOUNDARY FENCE LINE
- — AS BUILT CULVERTS
- 0.5% FALL ARROW
- — W BEAM BARRIER
- I.L. 4.62m — DRAINAGE INVERT LEVEL
- U/S I.L. 0.00 UPSTREAM INVERT LEVEL
- 225φ / 0.5% PIPE DIAMETER / GRADE
- 0.0m / RCP/2 LENGTH / MATERIAL / CLASS
- D/S I.L. 0.00 DOWNSTREAM INVERT LEVEL

PLAN

SCALE: 1:500

CULVERT SCHEDULE	OIP-7000-CI-SCH-1002						
STORMWATER DRAINAGE PLAN — SHEET 3 OF 4	OIP-7000-CI-PLN-1004	2	AS BUILT	16.04.25	RDJ	GT	GW
STORMWATER DRAINAGE PLAN — SHEET 2 OF 4	OIP-7000-CI-PLN-1003	1	REVISED SEAWALL LOCATION	08.07.22	PAN	GT	GW
STORMWATER DRAINAGE GENERAL ARRANGEMENT PLAN	OIP-7000-CI-PLN-1001	0	ISSUED FOR CONSTRUCTION	04.05.22	PAN	GT	GW
REFERENCE DRAWINGS:		REV	DESCRIPTION	DATE	DRN	CHK	APP



1 SLEAT ROAD, APPLECROSS | TELEPHONE (08) 9329 3400
WESTERN AUSTRALIA, 6153 | FACSIMILE (08) 9329 3401

DO NOT SCALE PRINT	PROJECT	OIP-ONSLow IRON PROJECT
	TITLE	PORT FACILITY — STAGE 2 EARTHWORKS AND DRAINAGE STORMWATER DRAINAGE PLAN — SHEET 4 OF 4
SCALE: 1:500	DRG No	OIP-7000-CI-PLN-1005
DRAWN: AC		
DATE: 13.08.21		
	REV	2